


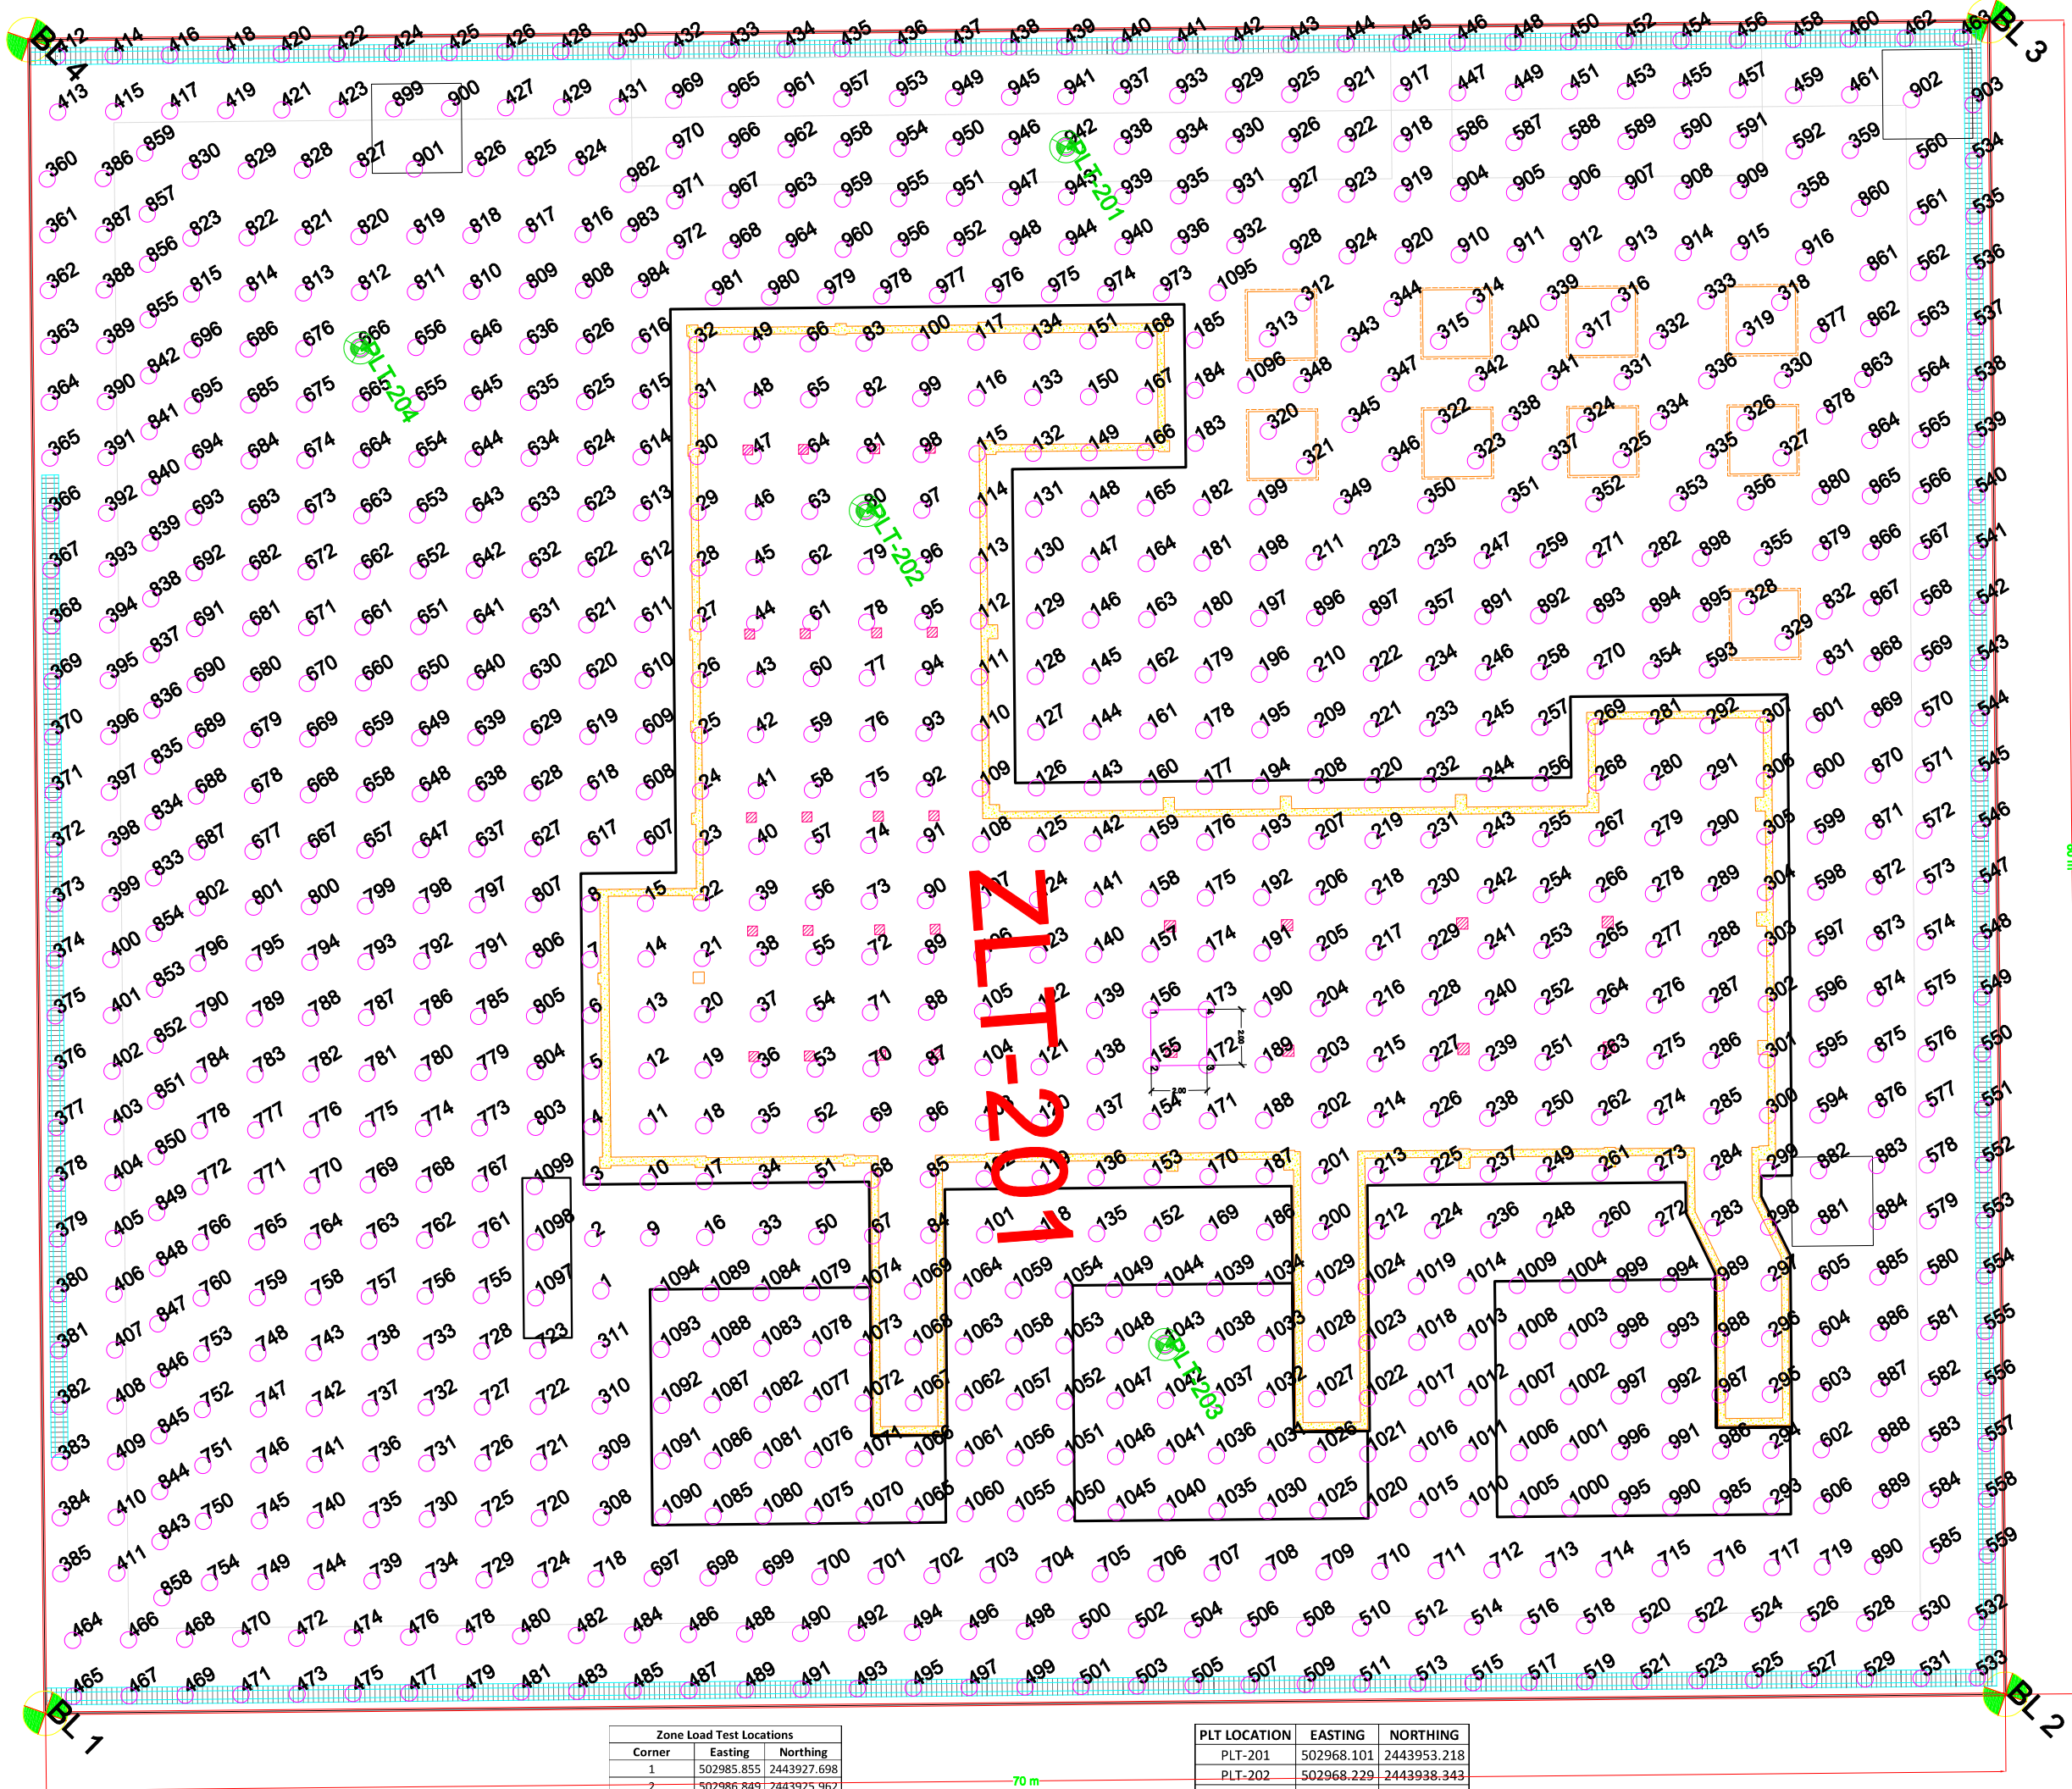


Zone Load Test Locations		
Corner	Easting	Northing
1	502985.855	2443927.698
2	502986.849	2443925.962
3	502988.585	2443926.957
4	502987.590	2443928.692

ZONE LOAD TEST

PLT LOCATION	EASTING	NORTHING
PLT-201	502968.101	2443953.218
PLT-202	502968.229	2443938.343
PLT-203	502992.168	2443917.485
PLT-204	502951.32	2443934.315

PLATE LOAD TEST

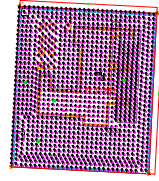

Key Plan

General Notes:

- 1) All dimension and coordinates are in meter.
- 2) Soil Improvement boundary by (70m x 60m)

Legend

- SI Boundary - 4200 m²
- CMC - 1099 No.
- PLATE LOAD TEST - 4 NOS
- ZONE LOAD TEST - 1No.

Boundary Limit	Easting	Northing
BL 1	502963.754	2443886.413
BL 2	503024.4991	2443921.223
BL 3	502994.6552	2443973.28
BL 4	502933.9196	2443938.474

0	15-01-25	ISSUED FOR APPROVAL	NAM	NE	HH

REVISIONS

Project Title
**JAZERA ROYAL PALACE 110/13.8
KV SUB STATION**

Client

الشركة السعودية للكهرباء
Saudi Electricity Company
تعمل بالثقة من أجلكم

Main Contractor:-

**NESMA
INFRASTRUCTURE
& TECHNOLOGY**

Sub Contractor:-

FREYSSINET MENARD SAUDI ARABIA
P.O.Box 6645, Riyadh 11431
Kingdom Of Saudi Arabia
Tel: + 966-14615247, 12933585
www.menard.ae


Title:-
**SOIL IMPROVEMENT
CMC AS BUILT LAYOUT**

Drawn by : NAM	Scale : NTS	Project no.
Checked by : NE	Date : 13-01-25	FMSA24047
Drawing No	REV.	
FMSA24047 -DWG-ABD-9001	0	